


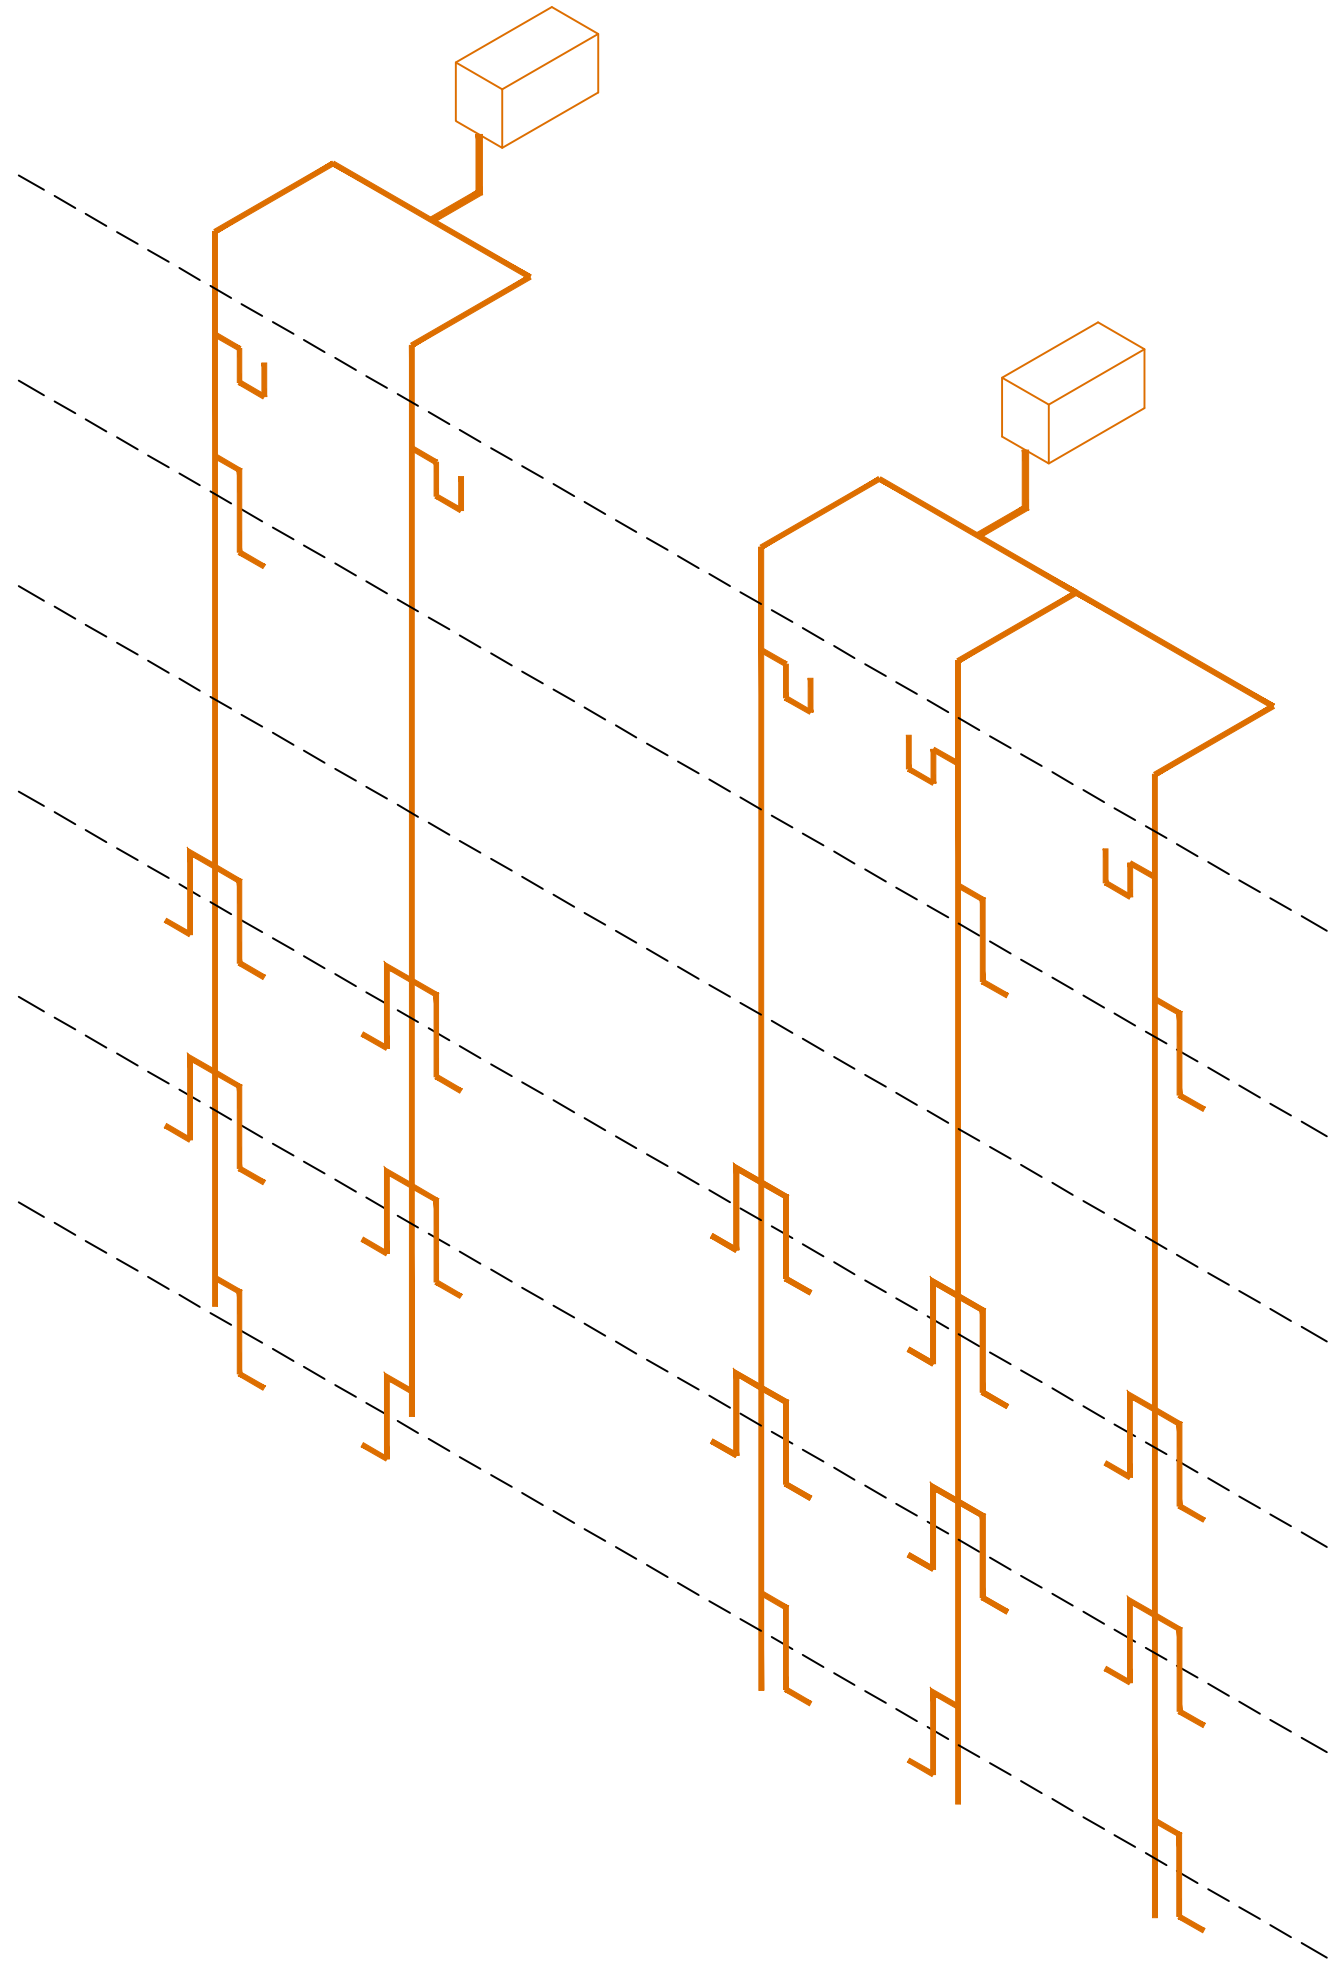

RECORD DRAWING

 Mole Business Park, Randalls Road, Leatherhead, Surrey, KT22 7BA			
CLIENT .			
PROJECT . . .			
TITLE .			
DATE .		DRAWN NRB	
SCALE 1:** @ A3	CAD No M-**	CHECKED JP	
DRG No ****-M-**			REV RD